



# City of Cambridge

## Purchasing Department

Cynthia H. Griffin  
*Purchasing Agent*

**TO:** All Bidders  
**FROM:** City of Cambridge  
**DATE:** January 18, 2013  
**RE:** File No. 5994 – Danehy Park Artificial Turf Field Project - Addendum No. 3

Please see attached questions and answers that were submitted.

All other details remain the same.

  
CYNTHIA H. GRIFFIN  
PURCHASING AGENT

Addendum No. 3



**Artificial Turf Field Project, Soccer Fields 1 and 2, Danehy Park, Cambridge, MA**

**ADDENDUM NO. 3**

Date Issued: January 17, 2013

**CONTRACTOR QUESTIONS AND RESPONSES**

Question #1:	The depth of the base stone on detail 6/L-6 is 8" and on detail 10/L-6 is 7". Please Confirm.
Response	Change depth of base stone on detail 10/L-6 to be 8".
Question #2:	A note on L-4 indicates a stone depth within the collector pipe of 12". Does that include the top stone? Detail 7/L-6 has a note that indicates 10" of base and top stone. Please confirm.
Response	Yes, the 12" stone depth within the collector drain shall have 2" top stone and 10" base stone. The 10" indicated is where the transition occurs from the collector pipe trench to the rest of field.
Question #3:	Does the 6" underdrain along the northeast side of the field continue under the 10-ft wide entrance walk?
Response	Yes, this drain continues through beneath the walk.
Question #4:	Where is the break line between the Type I and Type II stone trench?
Response	The break line shall be at Manhole #5.
Question #5:	The minimum depth of stone in the Type I trench is 8" on L-4 and 16" on detail 11/L-6. Please confirm.
Response	The depth shall be 16" minimum.
Question #6:	How many pedestrian gates require replacement?
Response	Include five pedestrian gates.
Question #7:	Can you please clarify the notes on sheet L-2. In particular the note in the center of the sheet that begins with "Remove" and ends with "L-4", note 7 and 11. Which one of these notes should we follow?
Response	Change Note #11 to minimum 4" depth.
Question #8:	Are we simply to get to subgrade, compact soil and build up with specified materials?

Response	Refer to notes on drawings.
Question #9:	Please confirm that it is the intention to permanently install (2) pairs of soccer goals.
Response	Yes, as discussed in 02901.
Question #10:	Please confirm the scale for sheet L-2.
Response	1"=20'-0"
Question #11:	Please provide a detail that shows the relationship of the new 4-ft CLF to the edge of the perimeter walkway around.
Response	See updated detail 3/L-5.
Question #12:	Detail 4/L-5 shows the 4-ft tall type 3 fencing for alternate #1. The detail shows a top rail, mid-rail and bottom rail. Please confirm the mid-rail is required.
Response	There shall be no mid-rail.
Question #14:	Please confirm that there are not any restrictions for the off-site disposal of the existing loam and gravel layer.
Response	The soils have not been tested. Clean top soil and sandy gravel are the only materials to be disposed of offsite. Both were supervised during installation of Phase I Danehy Park.

**Changes to the Drawings:**


On sheet L-6, Detail 10 CHANGE 7" layer base stone to "8-IN LAYER BASE OF BASE STONE"

On sheet L-4, CHANGE note "stone drainage trench type one, width varies, min. 8" depth" to "STONE DRAINAGE TRENCH TYPE ONE, WIDTH VARIES, MIN. 16" DEPTH"


On sheet L-2, CHANGE note 11 to "EXISTING LOAM AND SOD WITHIN THE FIELD AND PAVED AREAS SHALL BE REMOVED TO MINIMUM DEPTH OF 4-IN, OR AS OTHERWISE REQUIRED OR INDICATED TO INSTALL FIELD AND BASE MATERIALS. "

On Sheet L-2, ADD scale bar of 1"-20'-0".

On sheet L-5, REPLACE Detail 3 with the attached revised detail.

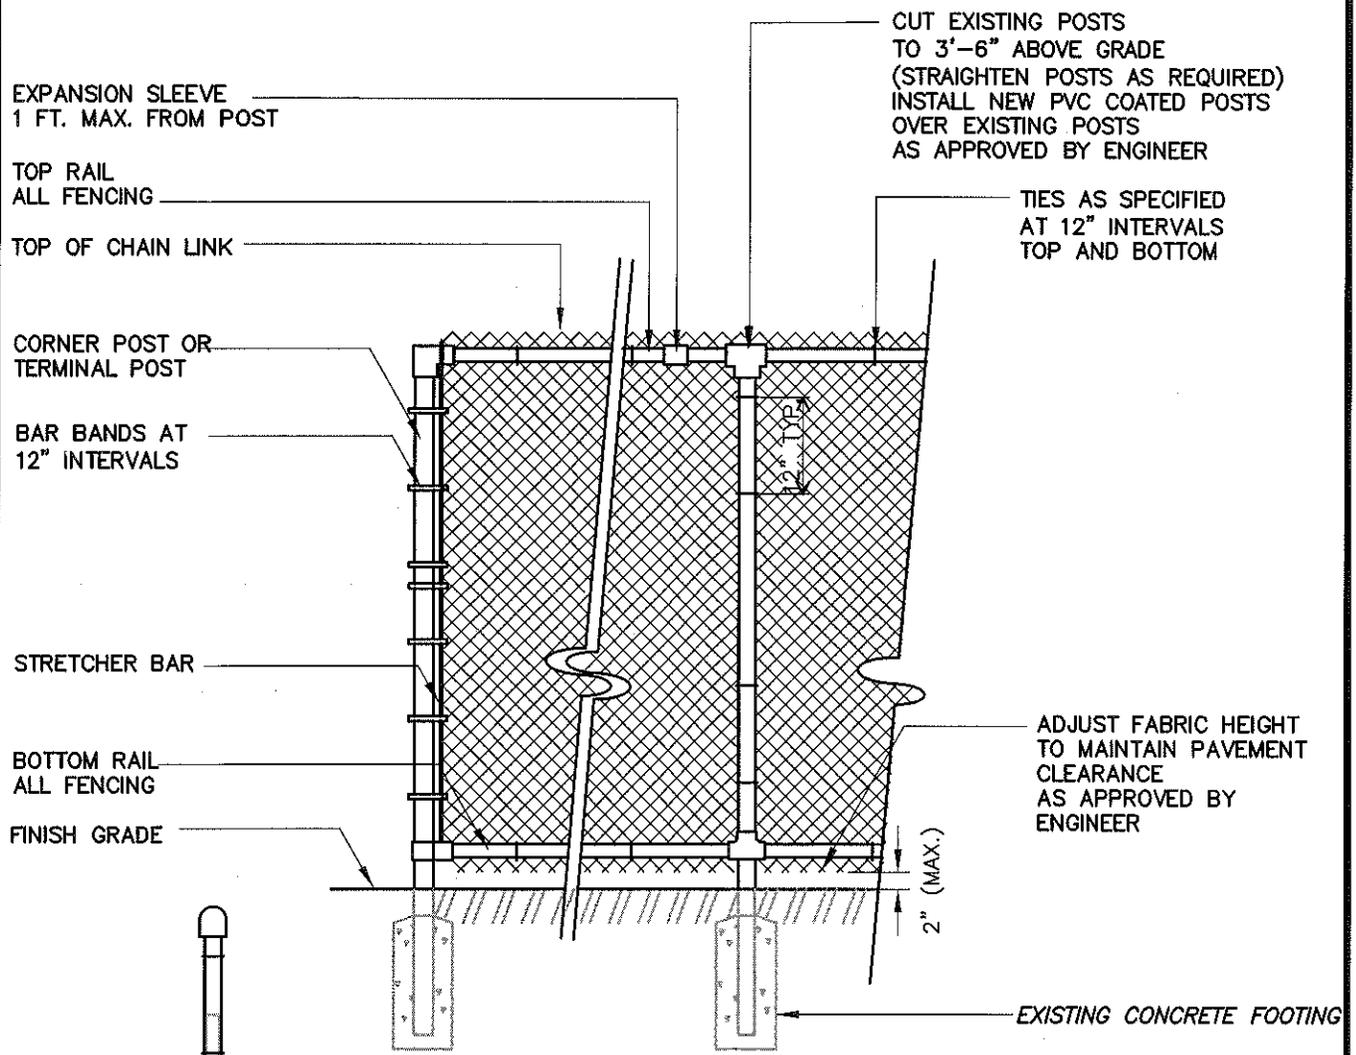

**ELEVATION**

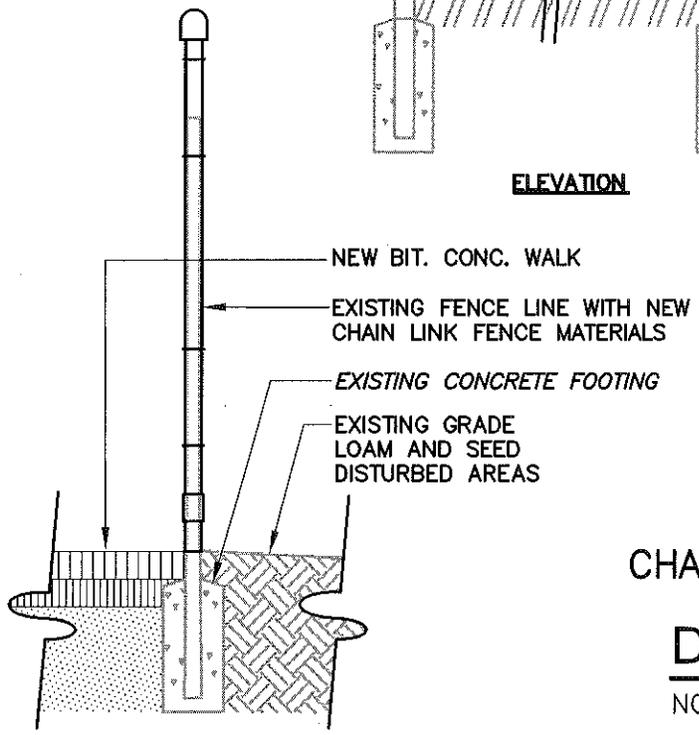

**SECTION**

**NOTE:**  
 FOR ALL TYPE 2 FENCE, REMOVE EXISTING CHAIN LINK FENCE FABRIC AND RAILS AS NOTED. CUT POSTS AND INSTALL NEW POSTS OVER EXISTING POSTS. INSTALL NEW 4-FT HIGH CHAIN LINK FENCE TO LIMITS SHOWN.

**CHAIN LINK FENCE TYPE 2**

**DETAIL**

NOT TO SCALE

3  
L-5



DATE <u>JAN 2013</u>	SHEET NO.		ADDENDUM NO.	FIGURE NO.
	ARTIFICIAL TURF FIELD PROJECT, DANEHY PARK	3		
		3		1